

Appendix E. Levee Erosion Data


Appendix E

Levee Erosion Data

Contents

1. 2017 Levee Topographic Transects (Ducks Unlimited)
2. 2018 Levee Topographic Transects (Ducks Unlimited)
3. 2015-2021 Cells 6 and 8 Levee Topographic Transects
4. May and December 2021 Levee Topographic Transects

Appendix E-1

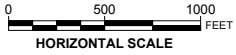






























Unauthorized Changes & Uses
The engineer preparing these plans will not be responsible for, or liable for, unauthorized changes to or uses of these plans. All changes must be in writing and must be approved by the preparer of these plans.



PROJECT NO. US-CA-461-3	DATE: 5/19/2017	DESIGNED BY: AP
SEARS POINT WETLAND RESTORATION EROSION ANALYSIS		DRAWN BY: JS
		SURVEYED BY: JM
		CHECKED BY:
SITE MAP		SHEET NO. 1 of 4

EXHIBIT

Appendix E-1

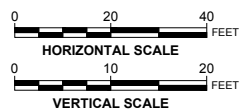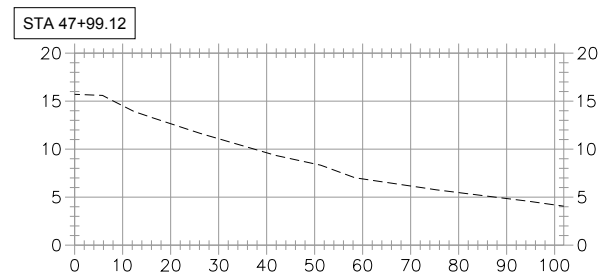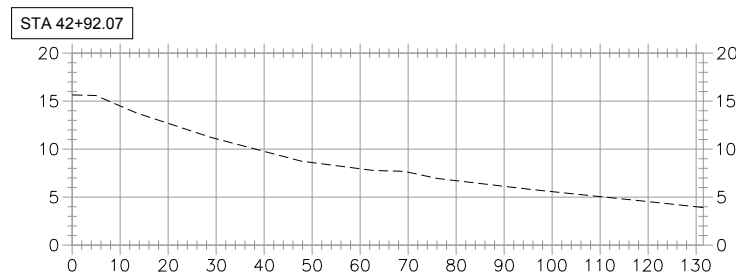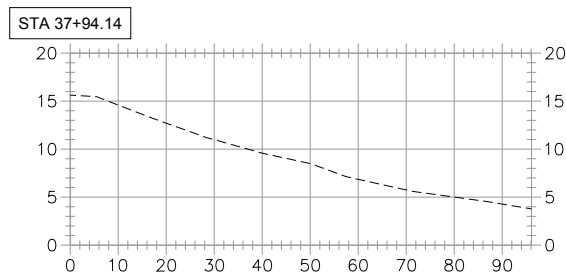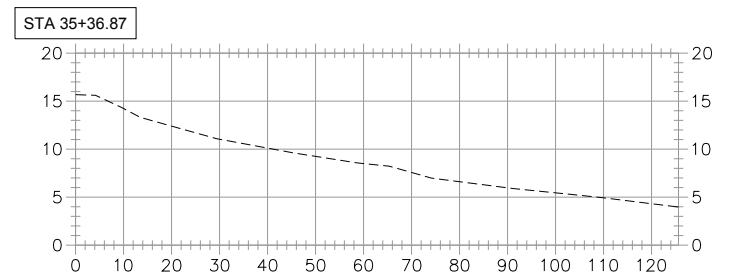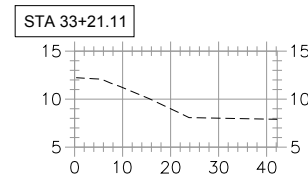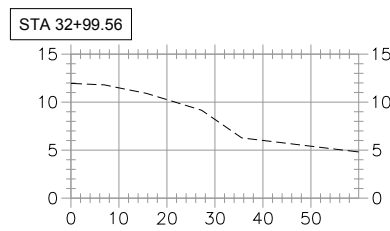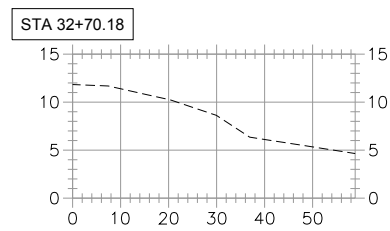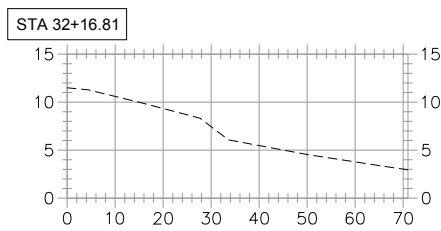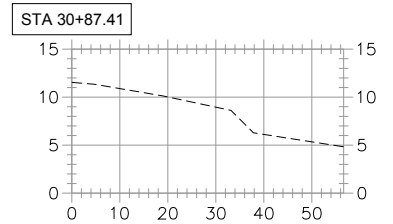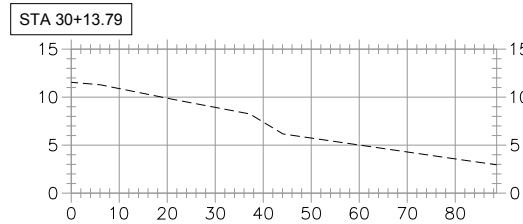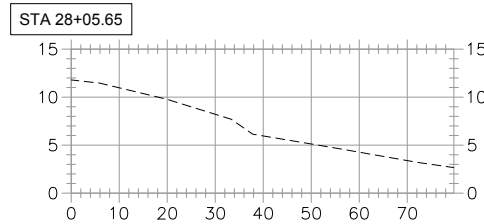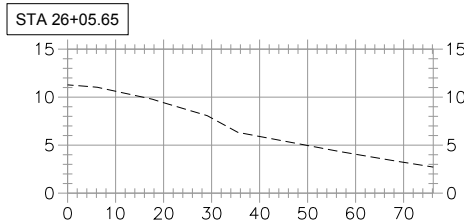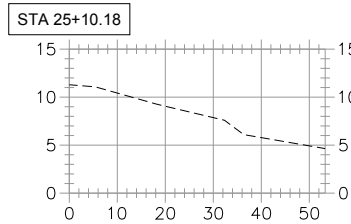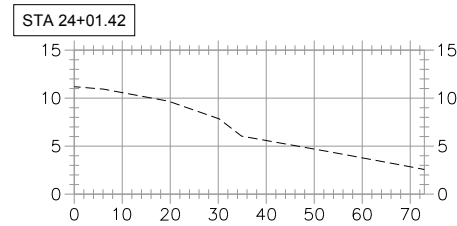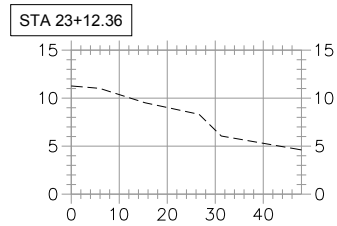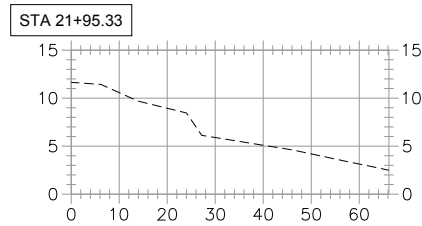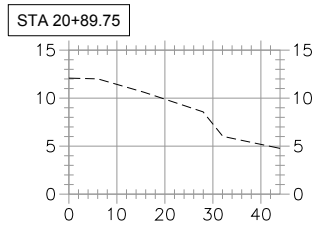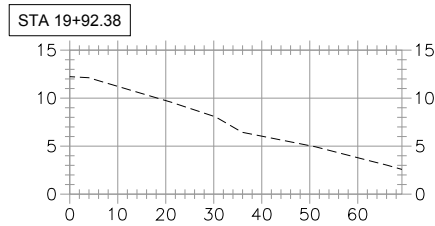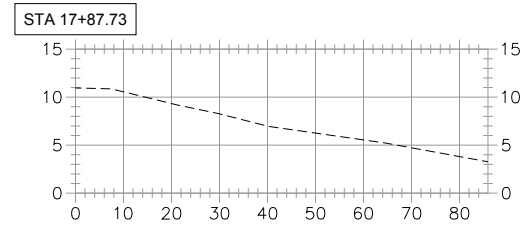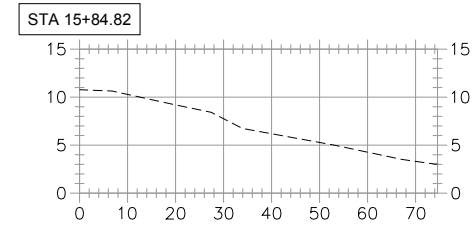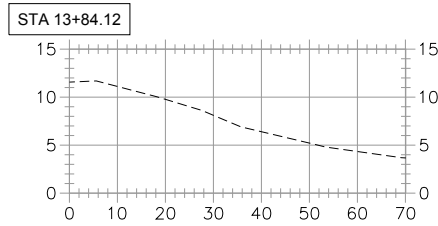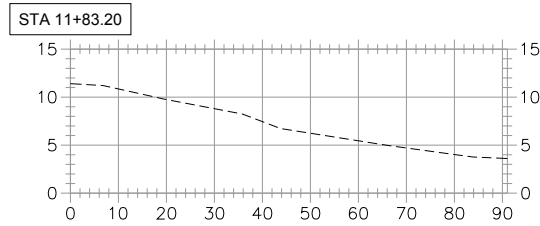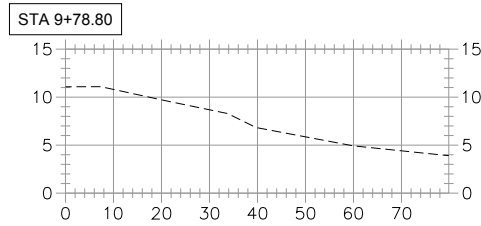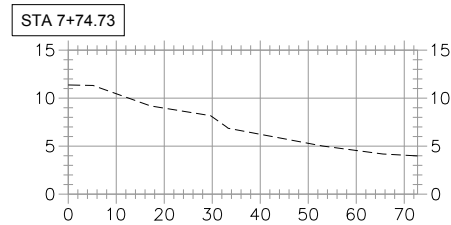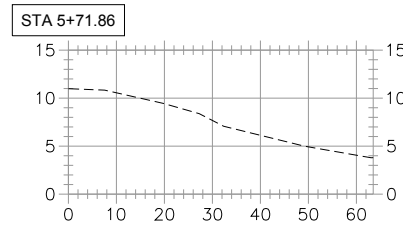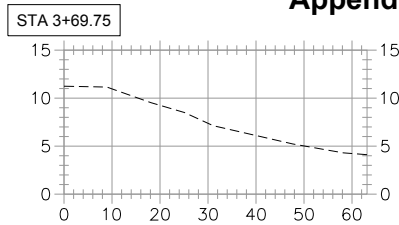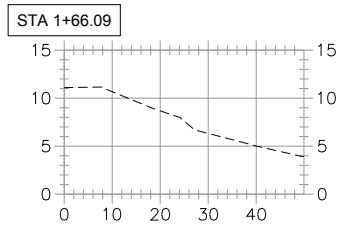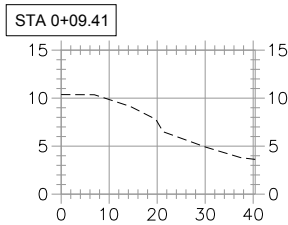

Unauthorized Changes & Uses























The engineer preparing these plans will not be responsible for, or liable for, unauthorized changes to or uses of these plans. All changes must be in writing and must be approved by the preparer of these plans.



PROJECT NO. US-CA-461-3	DATE: 5/19/2017	DESIGNED BY: AP
SEARS POINT WETLAND RESTORATION EROSION ANALYSIS		DRAWN BY: JS
		SURVEYED BY: JM
		CHECKED BY:
SECTIONS		SHEET NO. 2 of 4

EXHIBIT

Appendix E-1

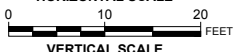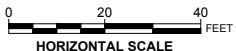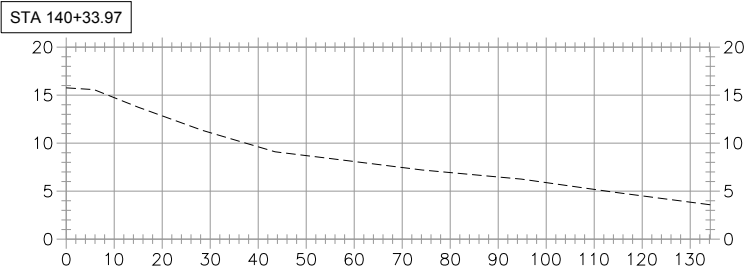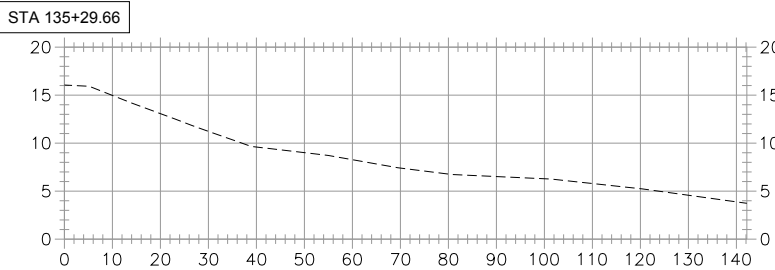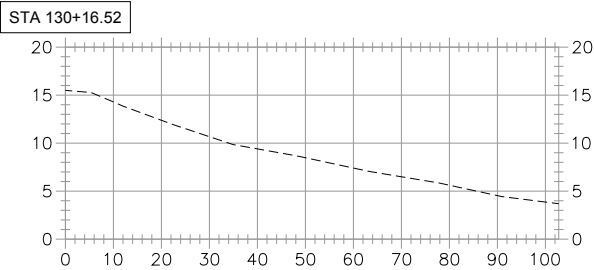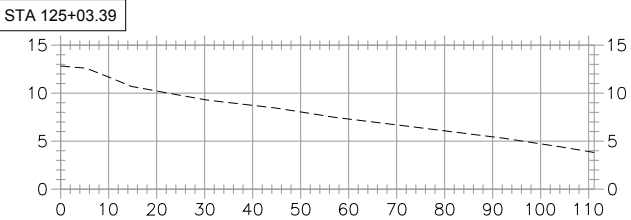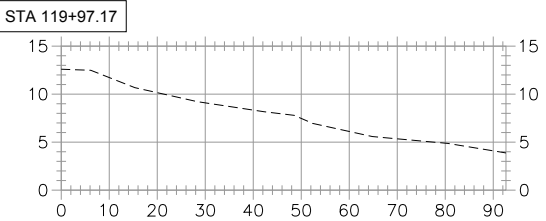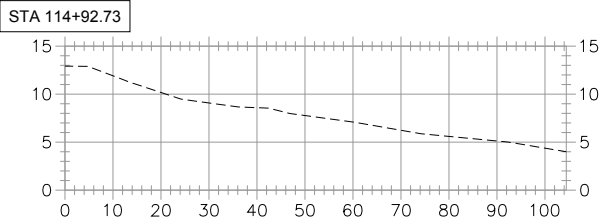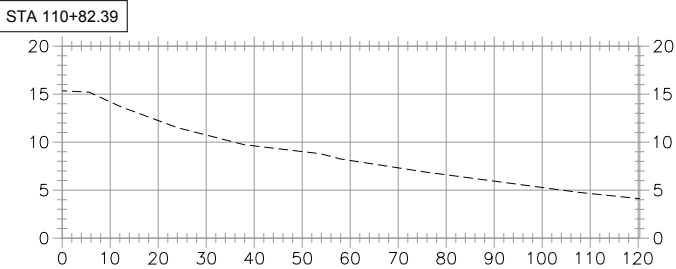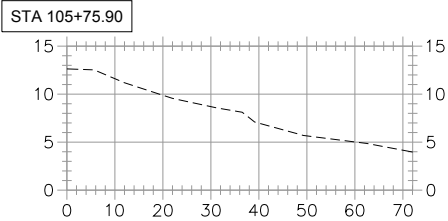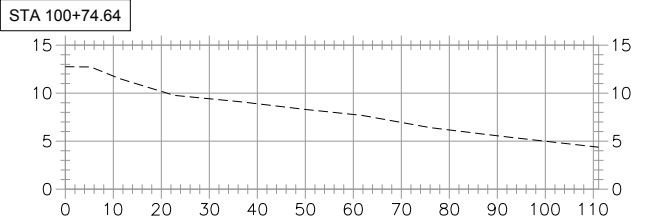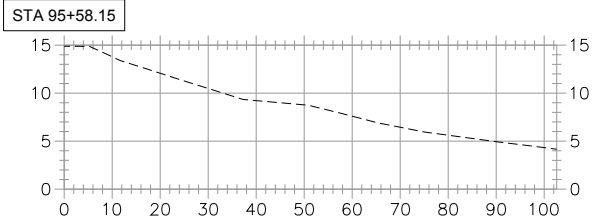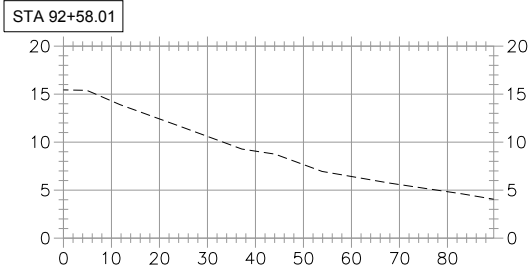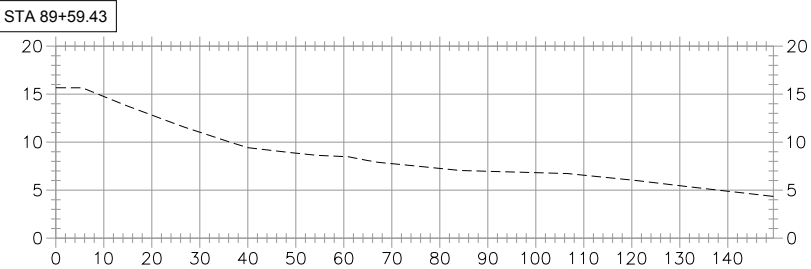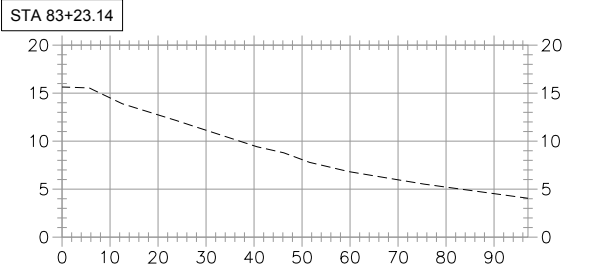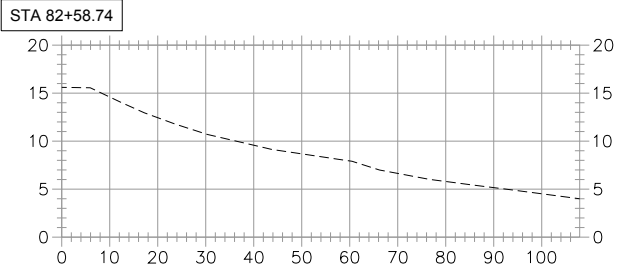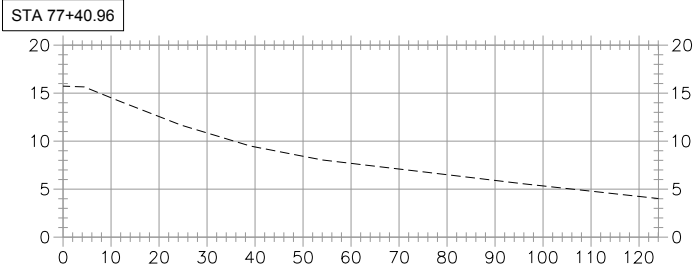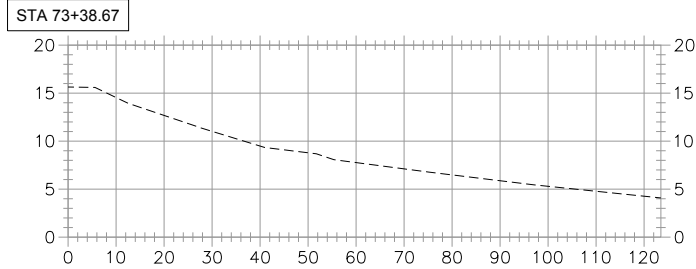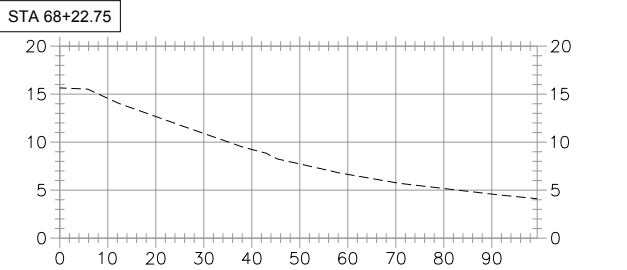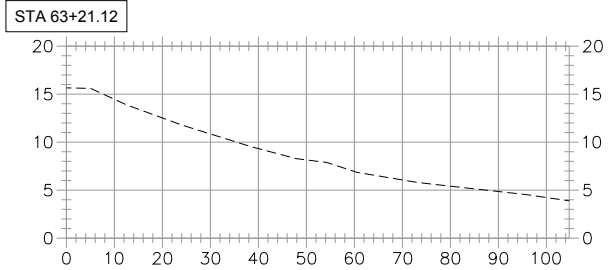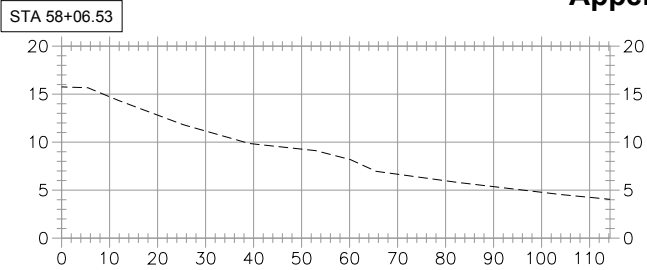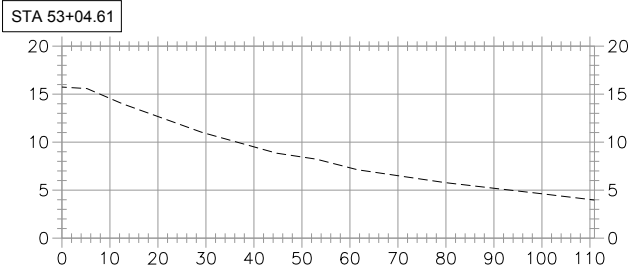

Unauthorized Changes & Uses



The engineer preparing these plans will not be responsible for, or liable for, unauthorized changes to or uses of these plans. All changes must be in writing and must be approved by the preparer of these plans.

EXHIBIT



PROJECT NO. US-CA-461-3	DATE: 5/19/2017	DESIGNED BY: AP
SEARS POINT WETLAND RESTORATION EROSION ANALYSIS		DRAWN BY: JS
		SURVEYED BY: JM
		CHECKED BY:
		SHEET NO. 3 of 4

K:\ACAD\CA\0461-003-BAFSEXHIBITS\Levee Cross Section Exhibit 2017\EROSION SECTIONS EXHIBIT.dwg, SH04, 5/19/2017 3:09:59 PM

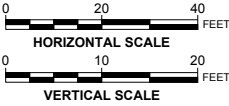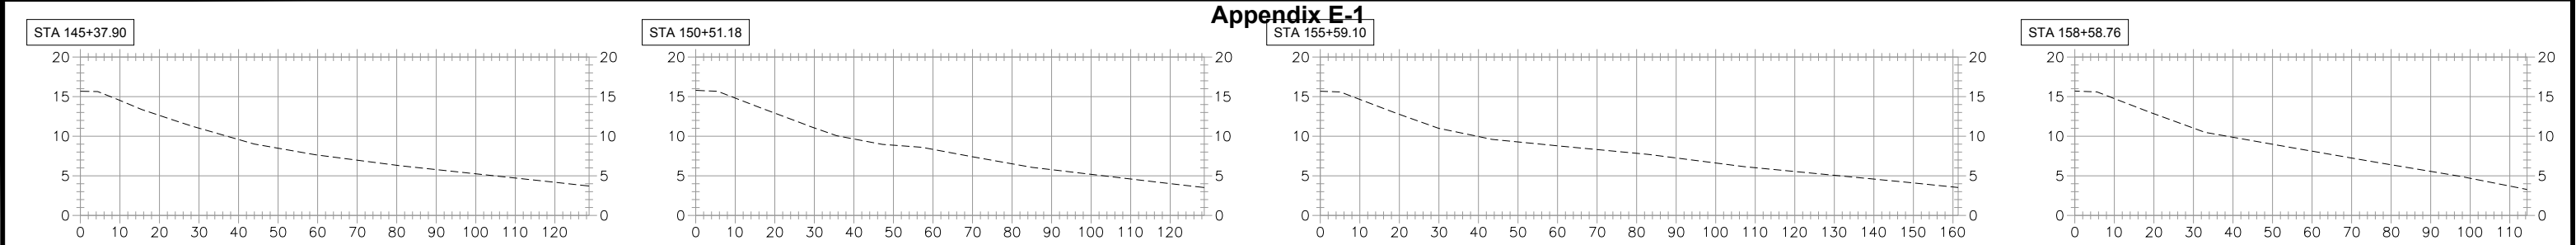

Unauthorized Changes & Uses

The engineer preparing these plans will not be responsible for, or liable for, unauthorized changes to or uses of these plans. All changes must be in writing and must be approved by the preparer of these plans.



PROJECT NO. US-CA-461-3	DATE: 5/19/2017	DESIGNED BY: AP
SEARS POINT WETLAND RESTORATION EROSION ANALYSIS		DRAWN BY: JS
		SURVEYED BY: JM
		CHECKED BY:
SECTIONS		SHEET NO. 4 of 4

EXHIBIT



SAN PABLO BAY



0 500 1000
HORIZONTAL SCALE
FEET

Unauthorized Changes & Uses

The engineer preparing these plans will not be responsible for, or liable for, unauthorized changes to or uses of these plans. All changes must be in writing and must be approved by the preparer of these plans.



PROJECT NO. **US-CA-461-3** DATE: **11/27/2018**

**SEARS POINT
WETLAND RESTORATION
EROSION ANALYSIS**

SITE MAP

DESIGNED BY: AP

DRAWN BY: JS

SURVEYED BY: JM

CHECKED BY:


SHEET NO.

1 of 3


EXHIBIT

TIDAL LEVEE


SECTION 25

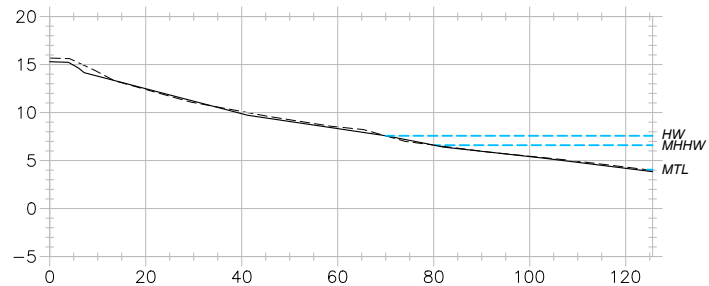


SECTION 29

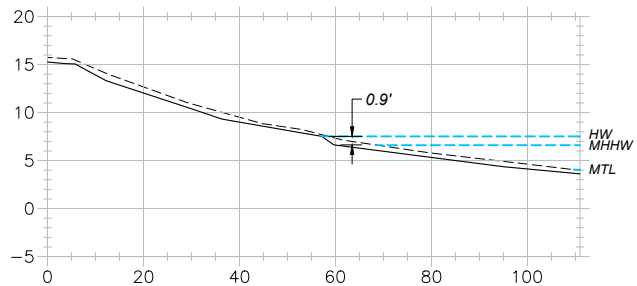


SECTION 33

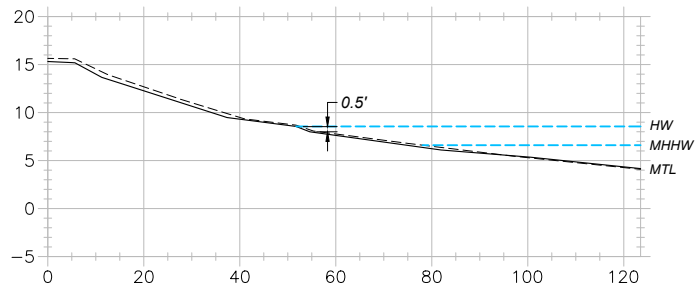


SECTION 37

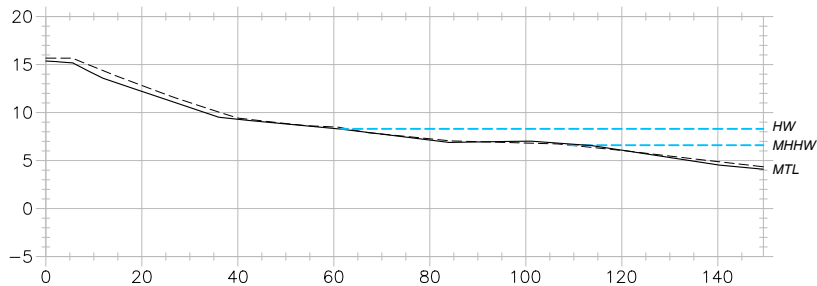


SECTION 26

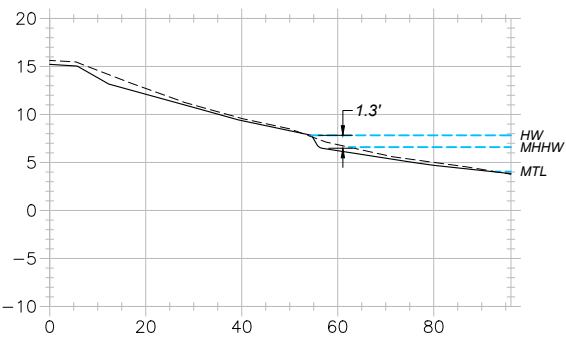


SECTION 30

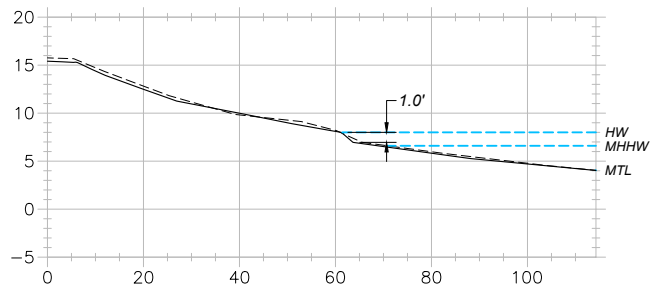


SECTION 34

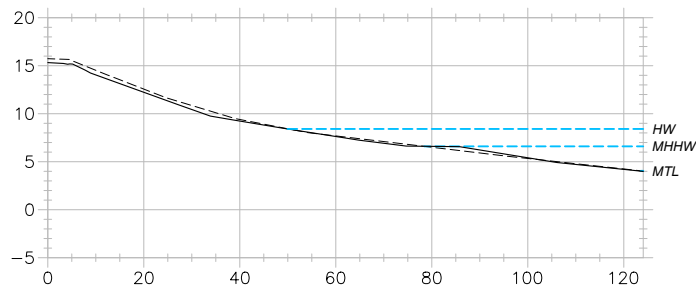


SECTION 38

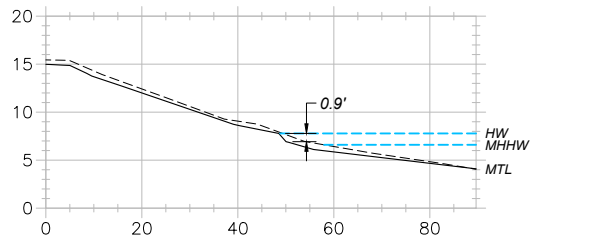


SECTION 27

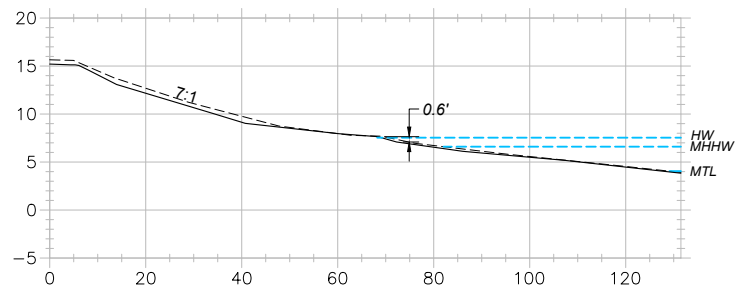


SECTION 31

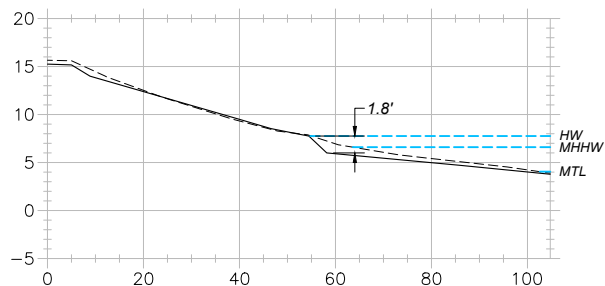


SECTION 35

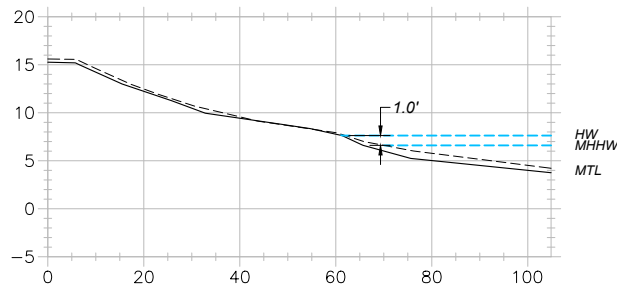


SECTION 39

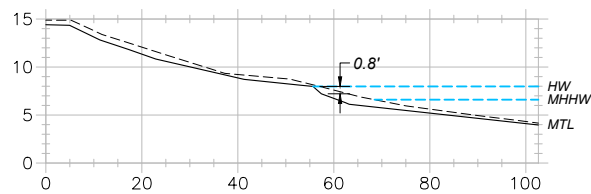


SECTION 28

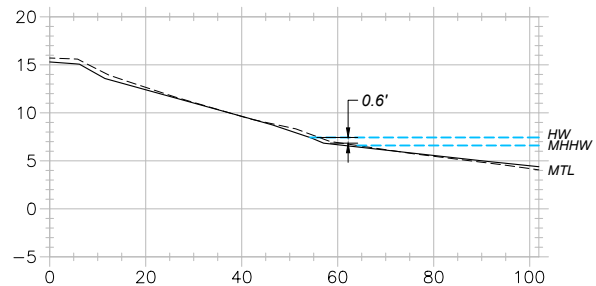


SECTION 32

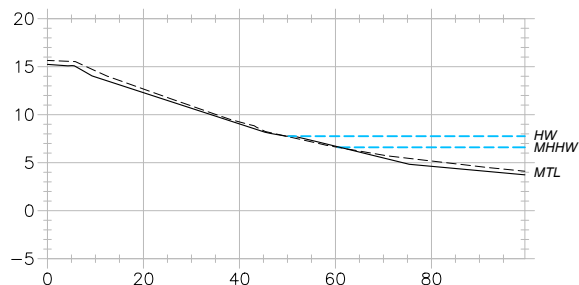



SECTION 36

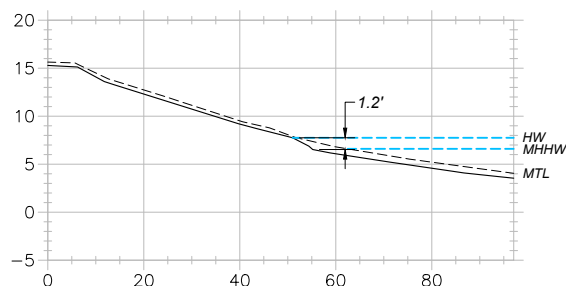

SECTION 40

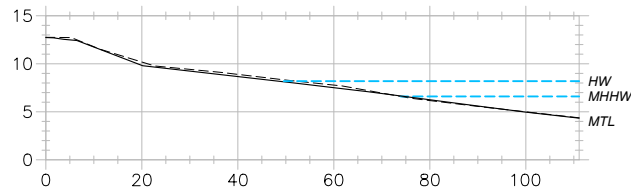

SECTION 41

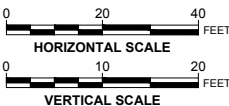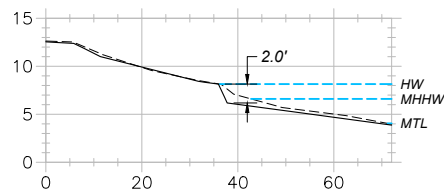

LEGEND

- Inspection survey (October, 2018)
- - - Post breach survey (May 2017, 18 months after the site was breached)
- - - Water Surface
- 1.5' Approximate height of scarp as dimensioned from the plans

- HW High Water Mark (Elevation Varies), surveyed from debris line 10/30/2018
- MHHW Mean Higher High Water (6.60ft) for B1-1, as modeled by Moffat and Nichol in their June 30, 2008 Addendum to the Hydrodynamic Modeling Analysis.
- MTL Mean Tide Level (4.05ft) for point B1-1, as calculated by Moffat and Nichol in their June 30, 2008 Addendum to the Hydrodynamic Modeling Analysis.

NOTE: ALL ELEVATIONS ARE IN FEET, NAVD88.












Unauthorized Changes & Uses
The engineer preparing these plans will not be responsible for, or liable for, unauthorized changes to or uses of these plans. All changes must be in writing and must be approved by the preparer of these plans.



PROJECT NO. US-CA-461-3	DATE: 11/27/2018	DESIGNED BY: AP
SEARS POINT WETLAND RESTORATION EROSION ANALYSIS		DRAWN BY: JS
TIDAL LEVEE SECTIONS		SURVEYED BY: JM
		CHECKED BY:
		SHEET NO. 2 of 3

EXHIBIT



TIDAL LEVEE

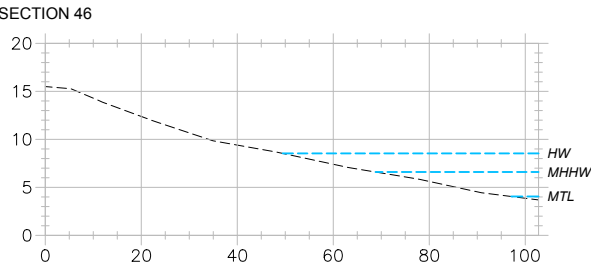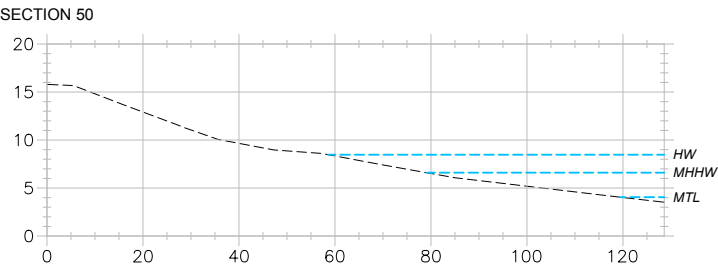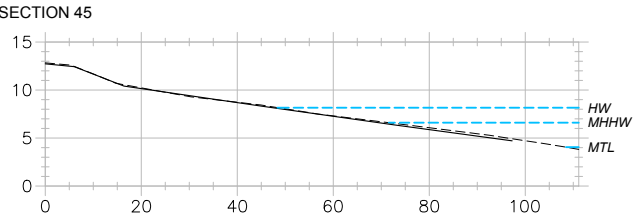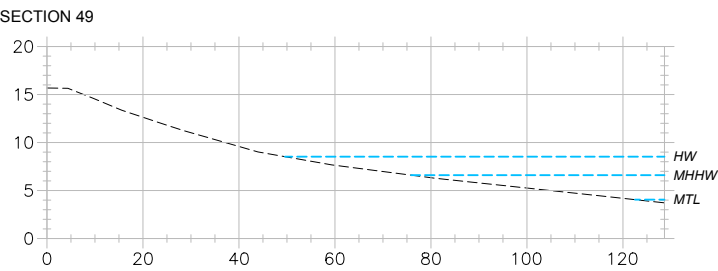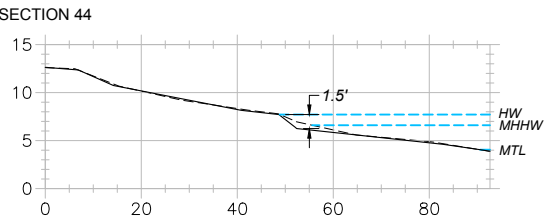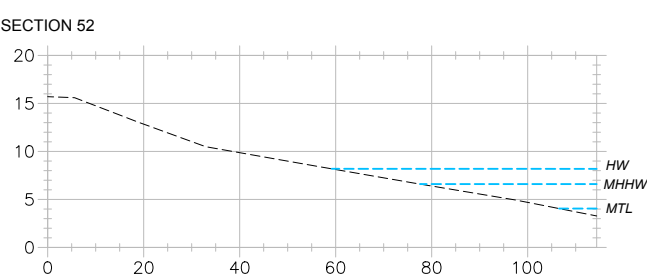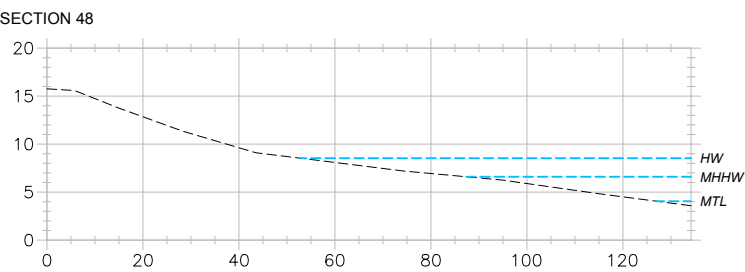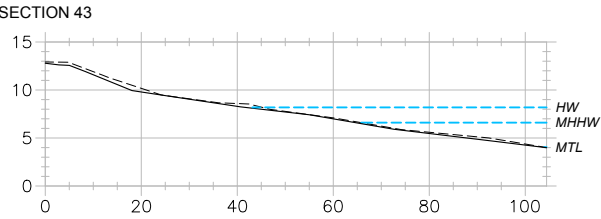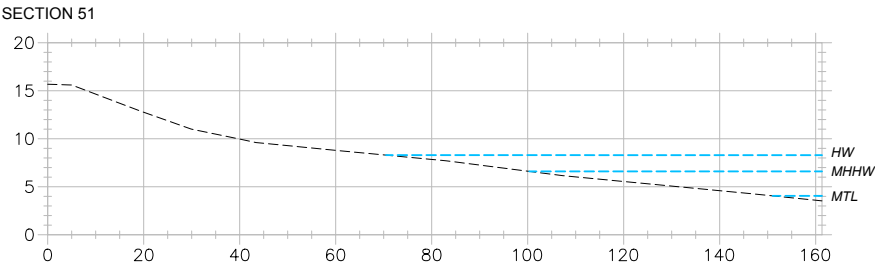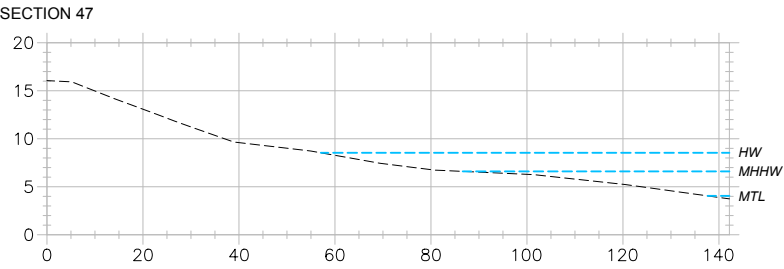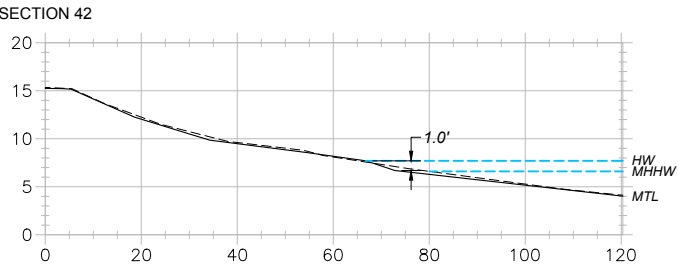

LEGEND

	Inspection survey (October, 2018)	HW	High Water Mark (Elevation Varies), surveyed from debris line 10/30/2018
	Post breach survey (May 2017, 18 months after the site was breached)	MHHW	Mean Higher High Water (6.60ft) for B1-1, as modeled by Moffat and Nichol in their June 30, 2008 Addendum to the Hydrodynamic Modeling Analysis.
	Water Surface	MTL	Mean Tide Level (4.05ft) for point B1-1, as calculated by Moffat and Nichol in their June 30, 2008 Addendum to the Hydrodynamic Modeling Analysis.
	Approximate height of scarp as dimensioned from the plans		

NOTE: ALL ELEVATIONS ARE IN FEET, NAVD88.

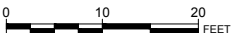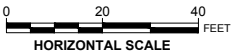

Unauthorized Changes & Uses


The engineer preparing these plans will not be responsible for, or liable for, unauthorized changes to or uses of these plans. All changes must be in writing and must be approved by the preparer of these plans.

EXHIBIT



PROJECT NO. US-CA-461-3	DATE: 11/27/2018	DESIGNED BY: AP
SEARS POINT WETLAND RESTORATION EROSION ANALYSIS		DRAWN BY: JS
		SURVEYED BY: JM
		CHECKED BY:
TIDAL LEVEE SECTIONS		SHEET NO. 3 of 3

Topographic Transects in Cells 6 and 7: 2015 As-built, 2017 and 2018 DU field data, 2018 and 2020 LiDAR DEM, 2021 SLT field data

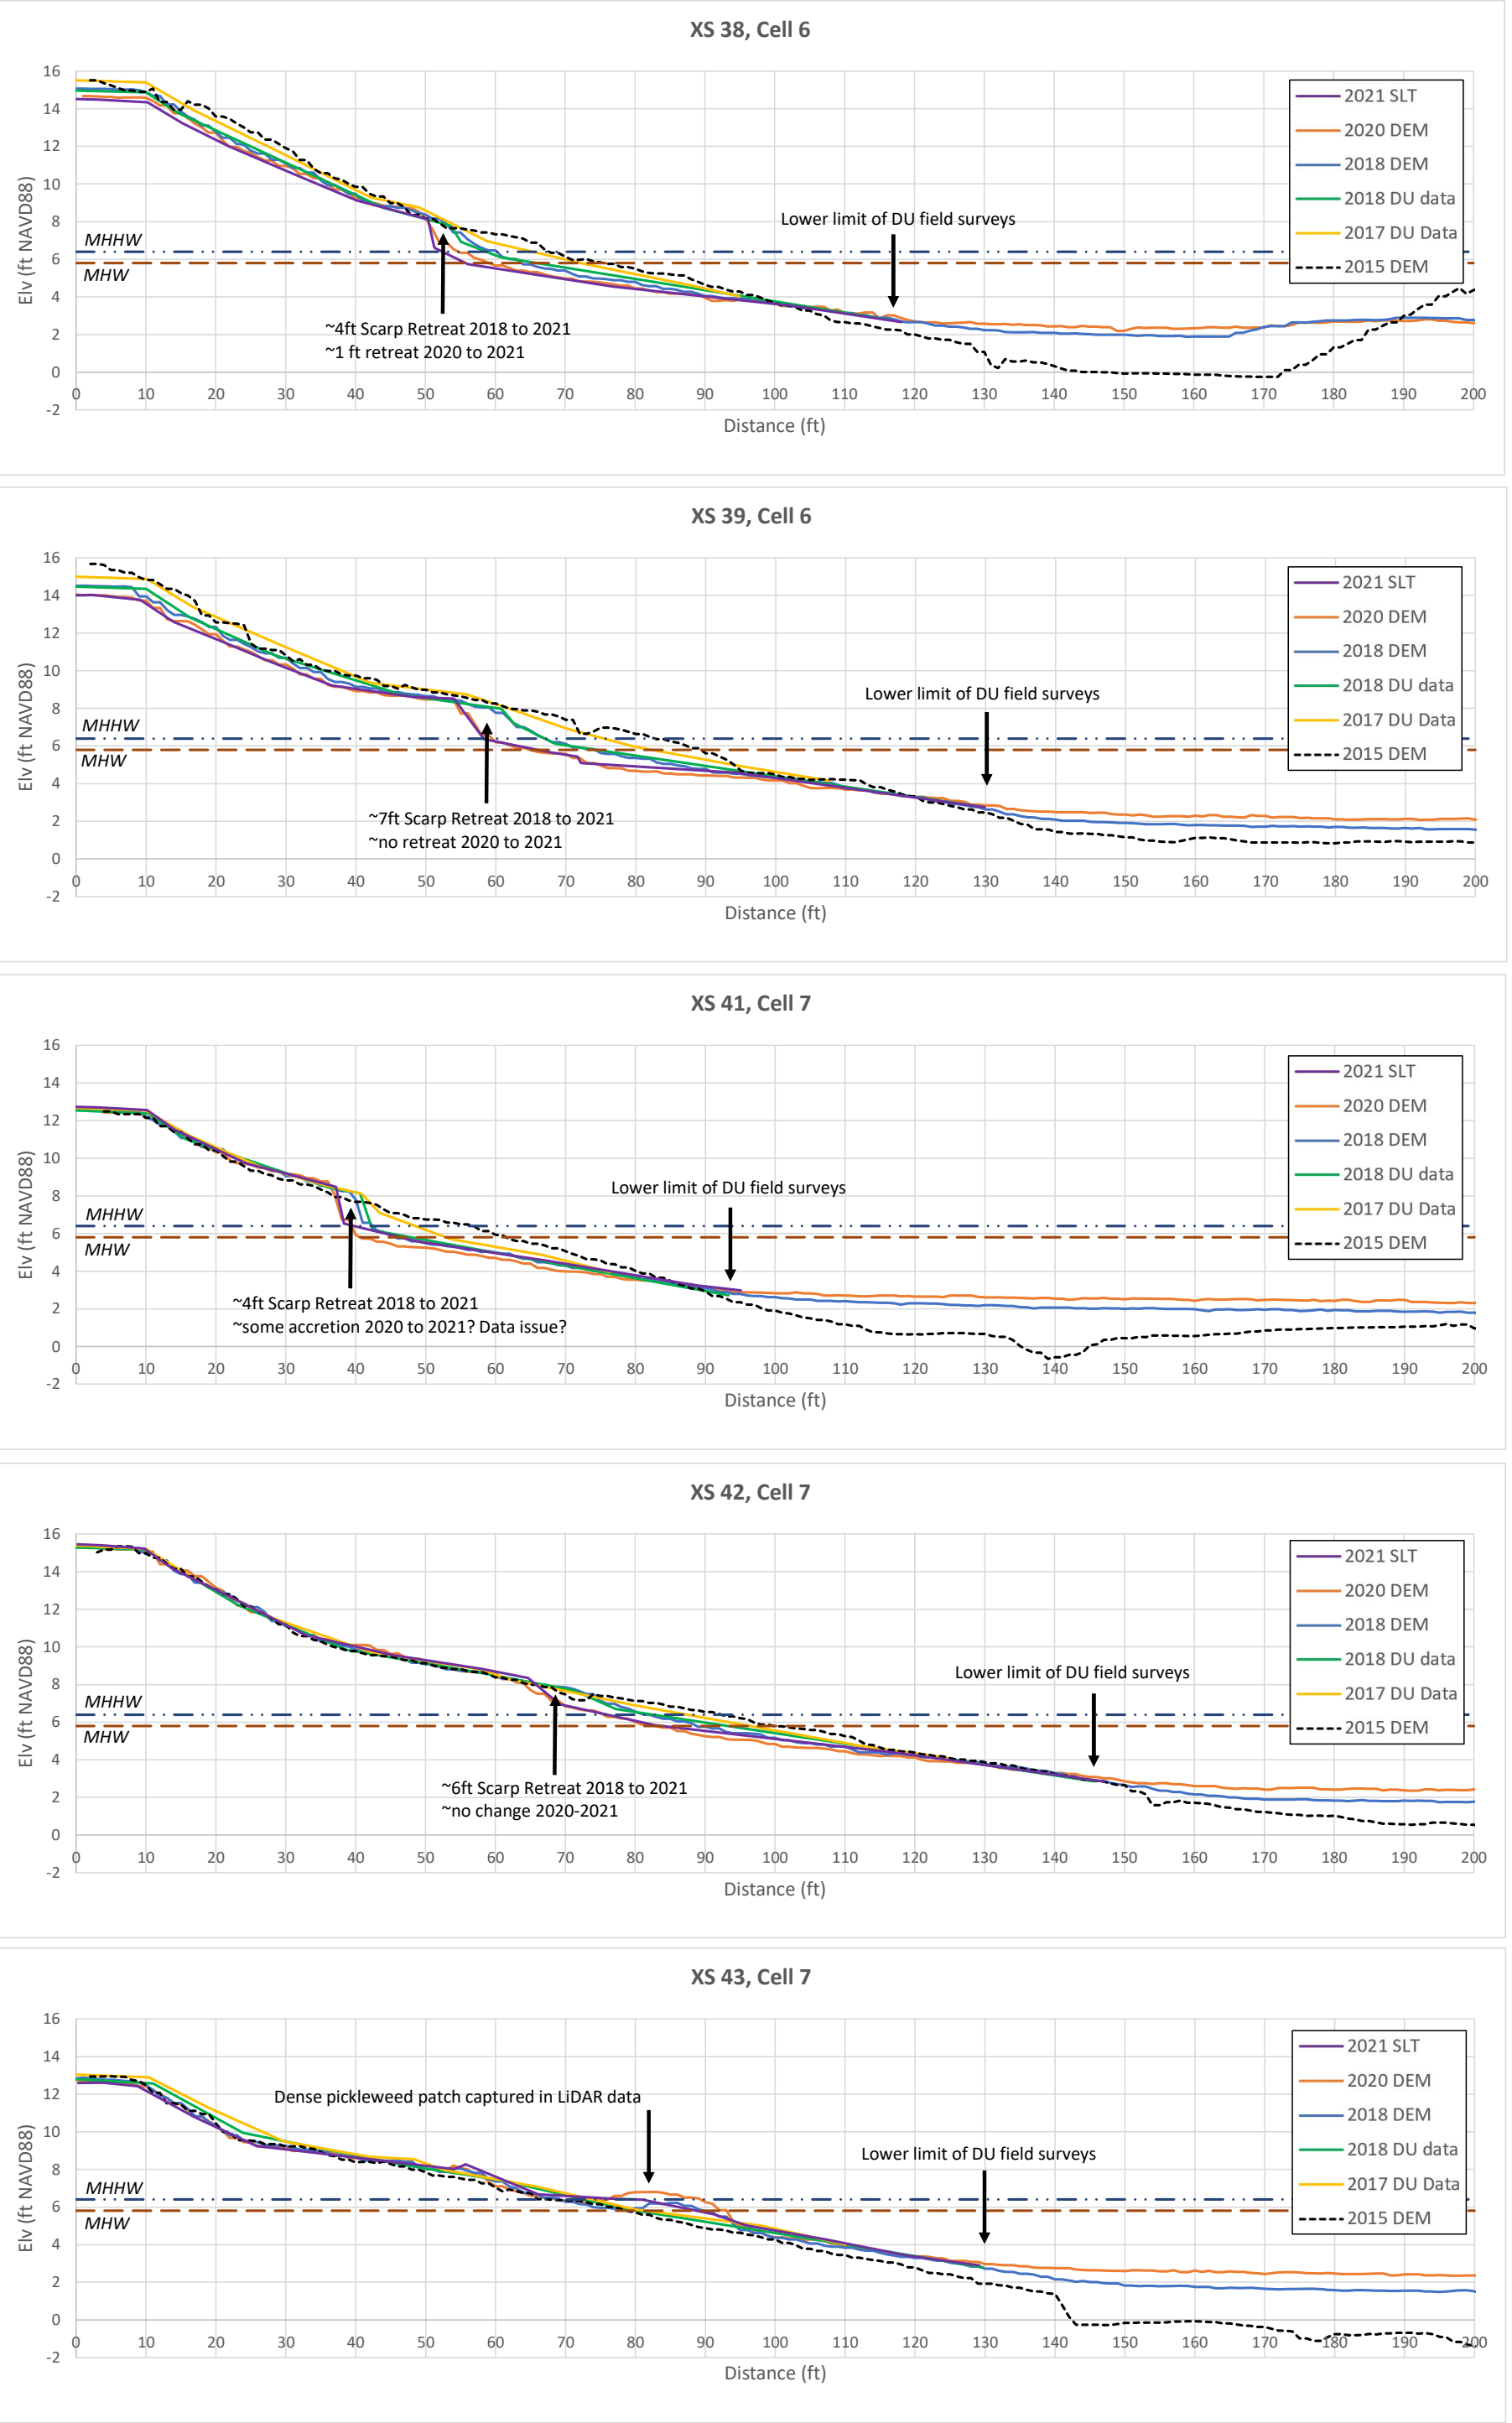

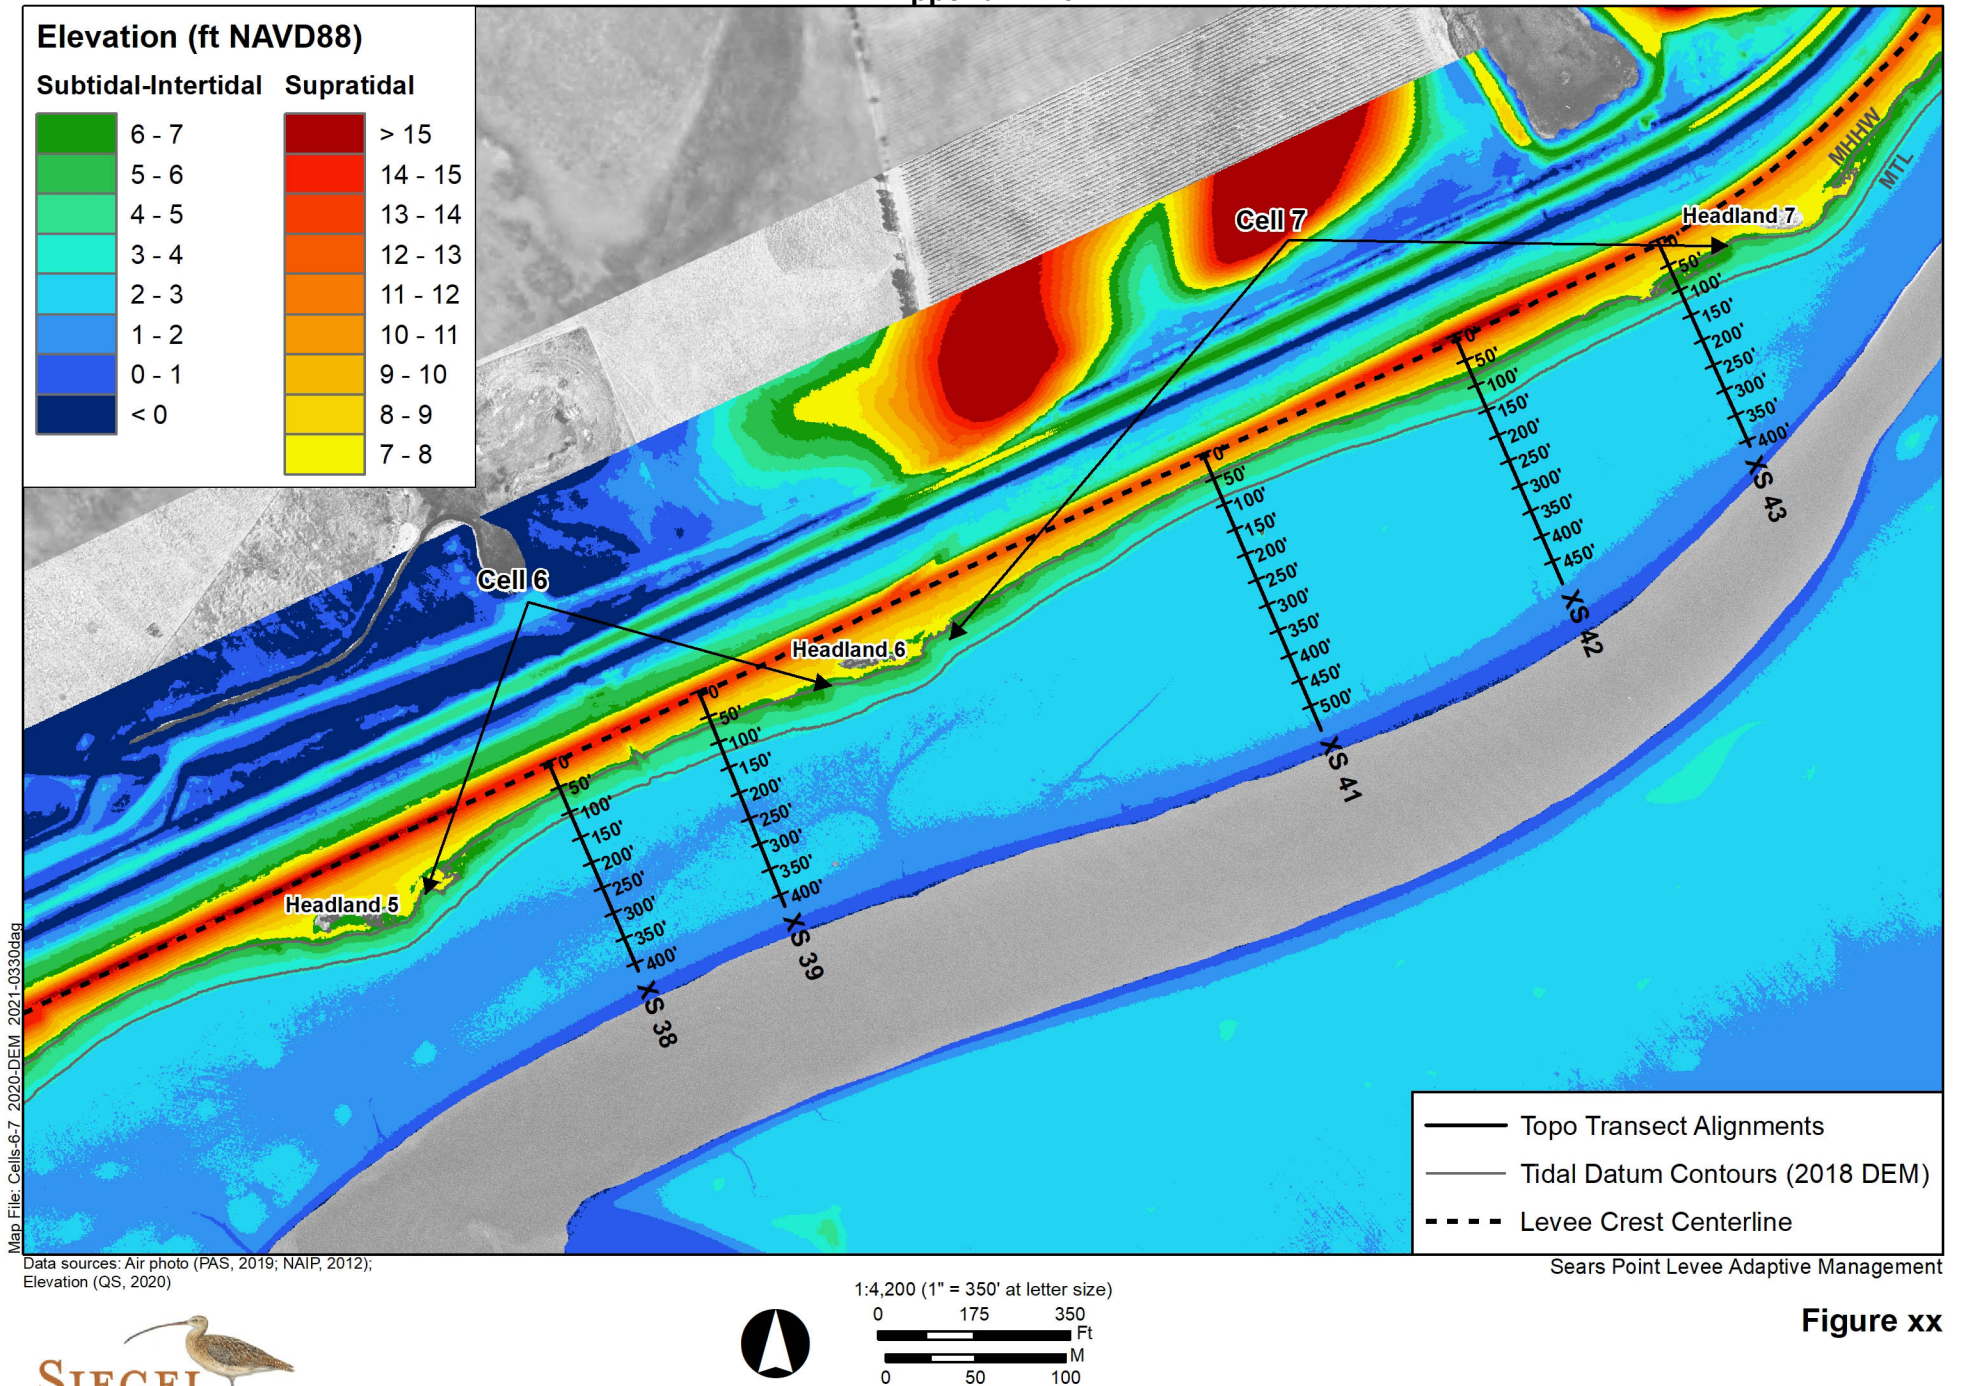


Figure xx

Cell 6-7 Intertidal Basin Elevation: 2020



Appendix E-4

Map Legend

Design Treatments

Treatment Approach	Scarp Grading	LWD Placement	Mud Placement	Brush Fence	Veneer (lower)
No Color Approach A			NO TREATMENT		
Approach B					
Approach C					
Approach D					
Approach E					
Approach F					
Approach G					
Approach H					
Approach I					

Field Added Treatments


















- Mud Placement (above MHHW)
- Gravel Toe Berm (above MHHW)
- Gravel Veneer (above MHHW)
- Topographic Sections

Topographic Section Plot Legend

- Pre-Construction Topography
- Post-Construction Topography

Notes

- Post-construction (as-built) topography surveyed by Dixon Marine Services between November 5 and 26, 2021 using RTK GPS.
- Pre-construction topography is from the following sources:
 - Sections 11 - 47: May 6, 2021 topographic survey performed by Daniel Harris of SFSU using RTK GPS.
 - Sections 101 - 121: June 2020 LiDAR digital elevation model (DEM) of Sears Pt Restoration Project site by Quantum Spatial.
- Topographic survey data are held to the benchmark network shown on Sheet 2
- Considerations for 2020 LiDAR data:
 - Data gaps along sections are due to the presense of standing water at the time of LiDAR acquisition.
 - Vegetation interference may be present in some locations, resulting in artificially high elevations.

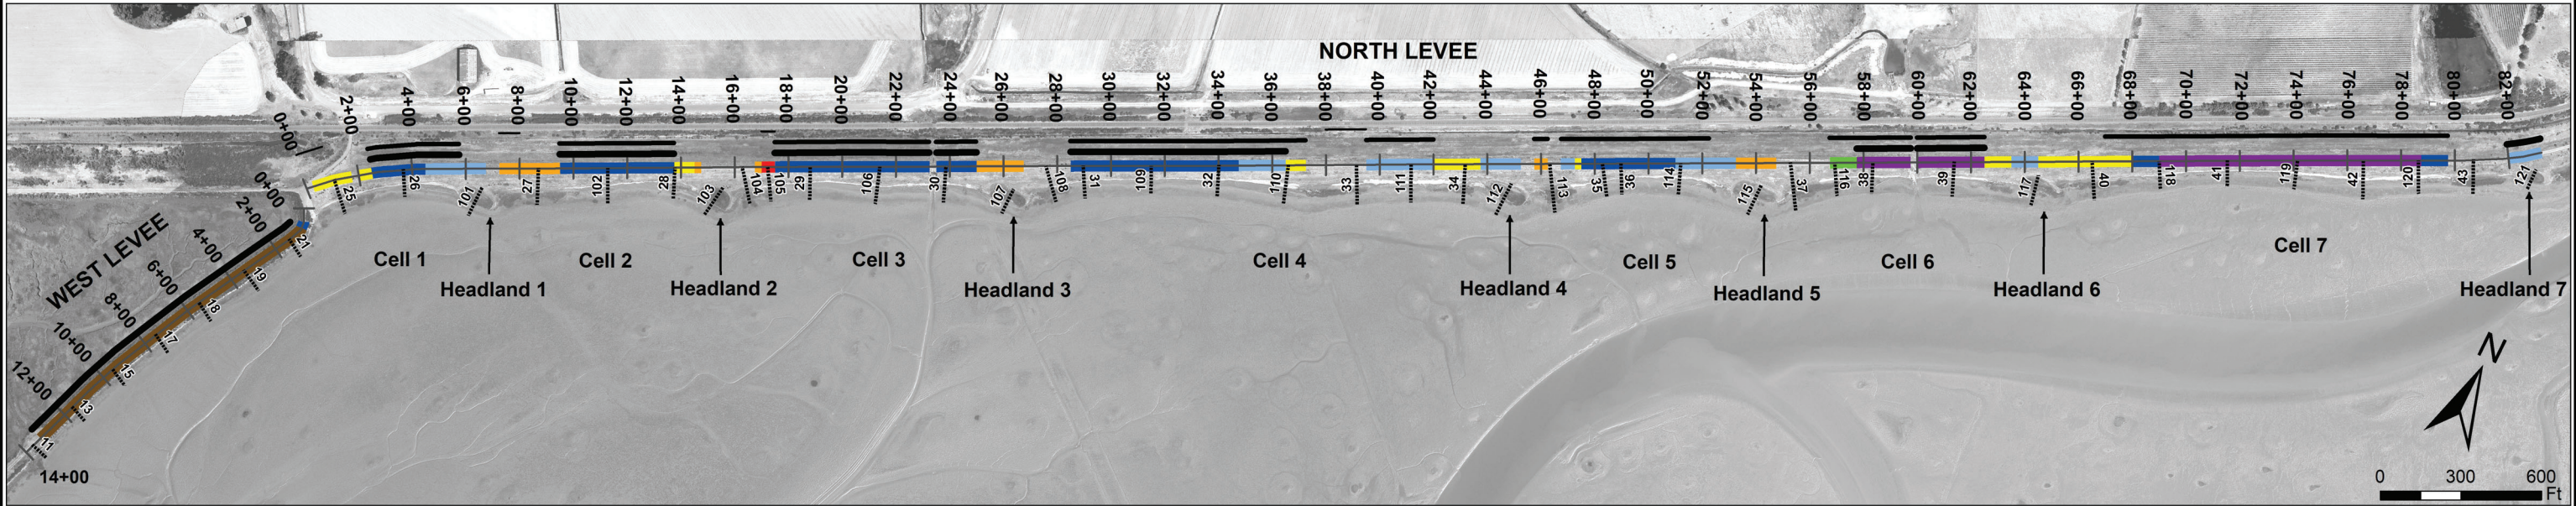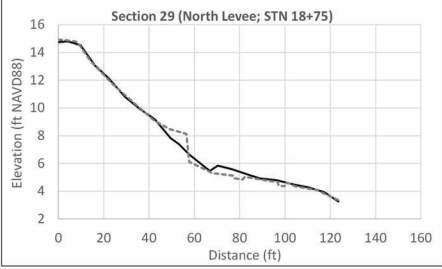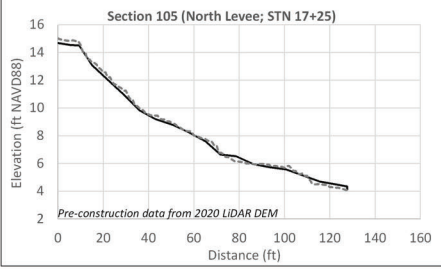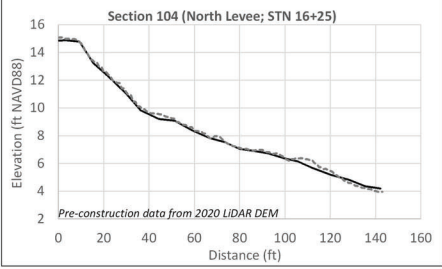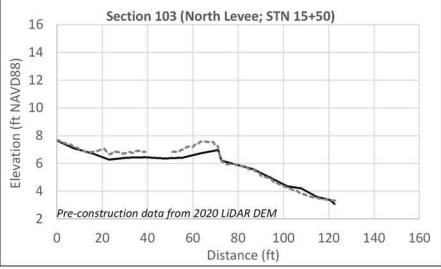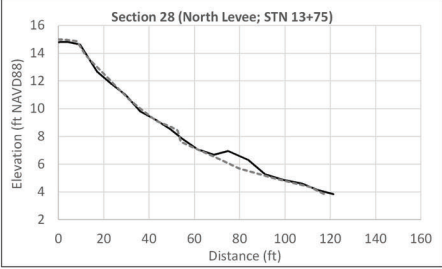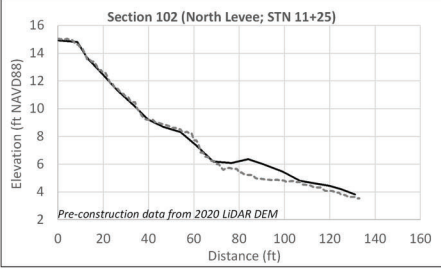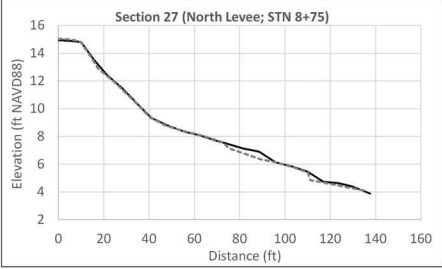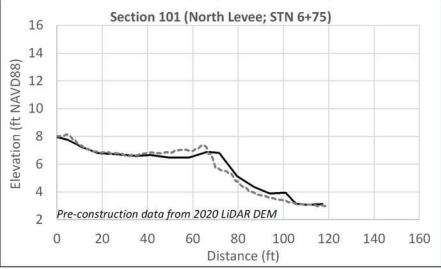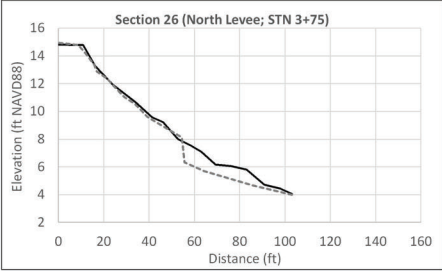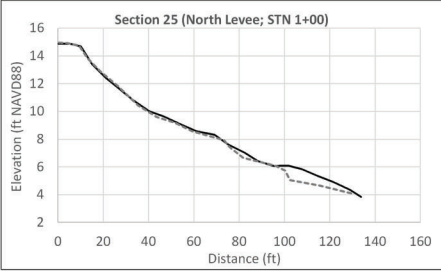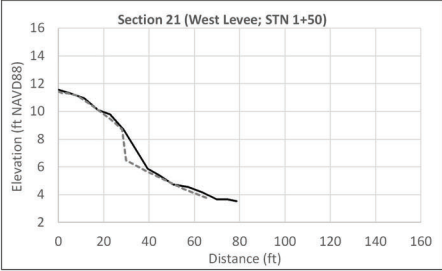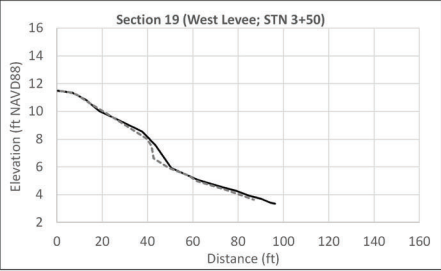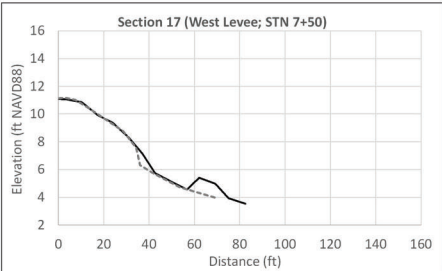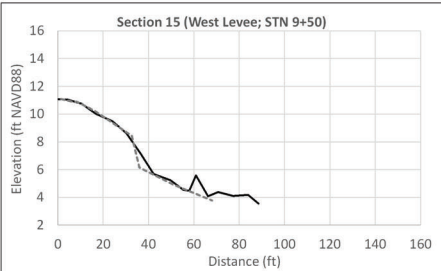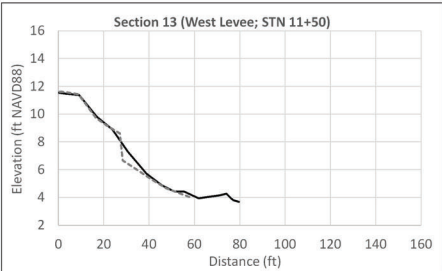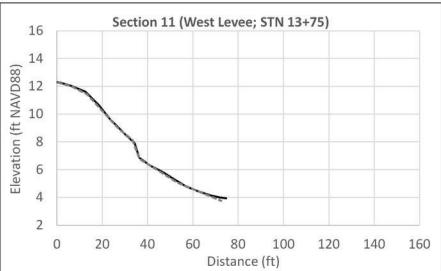

NUMBER	DATE	DESCRIPTION	BY	REVISION BLOCK	DRAWN BY: DAG	DESIGNED BY: PRB, RDL, SWS, DAG	CHECKED BY: RDL	SCALE: 1:3,600	Submitted: _____	Principal Civil Engineer	APPROVED BY: _____	PERMITTEE: _____	DATE: _____	SHEET: 9	PROJECT NO. 3021
--------	------	-------------	----	----------------	---------------	---------------------------------	-----------------	----------------	------------------	--------------------------	--------------------	------------------	-------------	----------	------------------

Map Legend

Design Treatments

Treatment Approach	Scarp Grading	LWD Placement	Mud Placement	Brush Fence	Veneer (lower)
No Color Approach A			NO TREATMENT		
Approach B					
Approach C					
Approach D					
Approach E					
Approach F					
Approach G					
Approach H					
Approach I					

Field Added Treatments


















- Mud Placement (above MHHW)
- Gravel Toe Berm (above MHHW)
- Gravel Veneer (above MHHW)
- Topographic Sections

Topographic Section Plot Legend

- Pre-Construction Topography
- Post-Construction Topography

Notes

- Post-construction (as-built) topography surveyed by Dixon Marine Services between November 5 and 26, 2021 using RTK GPS.
- Pre-construction topography is from the following sources:
 - Sections 11 - 47: May 6, 2021 topographic survey performed by Daniel Harris of SFSU using RTK GPS.
 - Sections 101 - 121: June 2020 LiDAR digital elevation model (DEM) of Sears Pt Restoration Project site by Quantum Spatial.
- Topographic survey data are held to the benchmark network shown on Sheet 2
- Considerations for 2020 LiDAR data:
 - Data gaps along sections are due to the presense of standing water at the time of LiDAR acquisition.
 - Vegetation interference may be present in some locations, resulting in artificially high elevations.

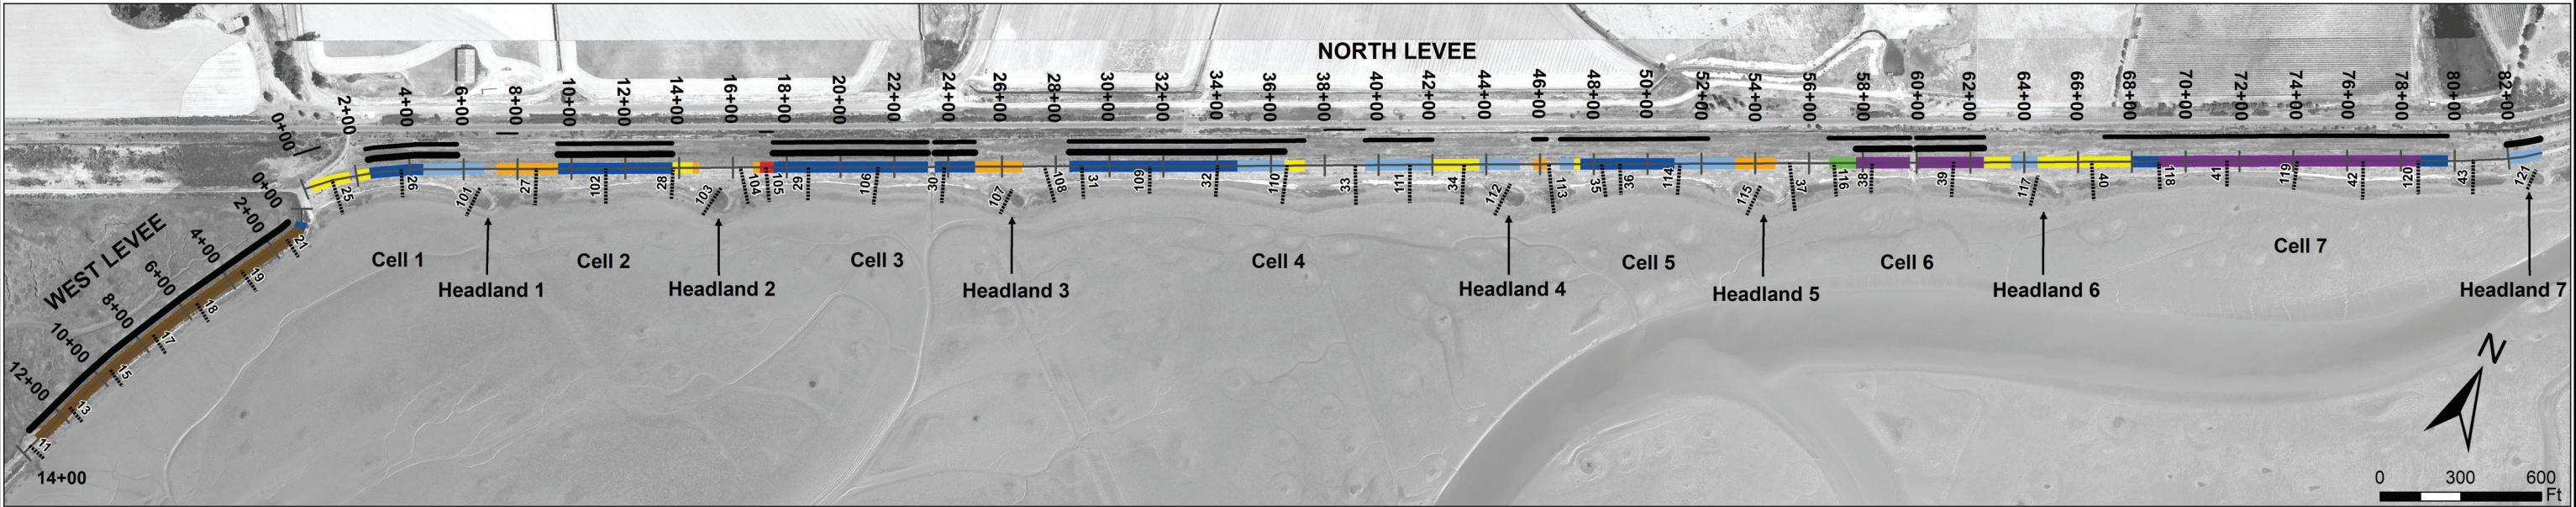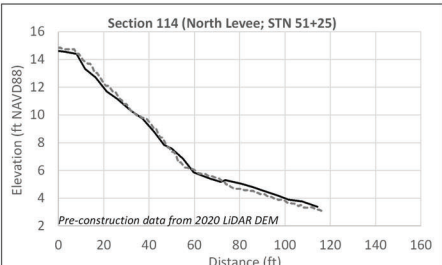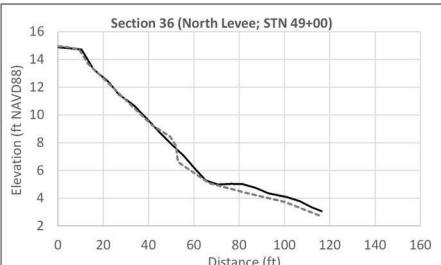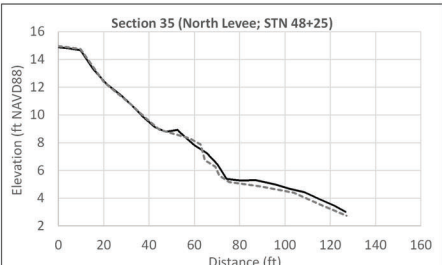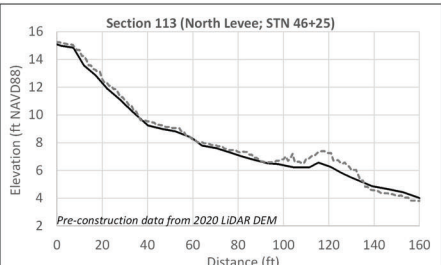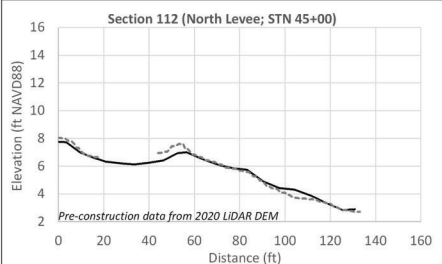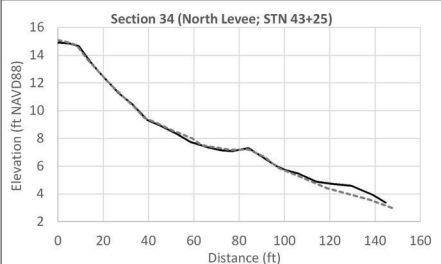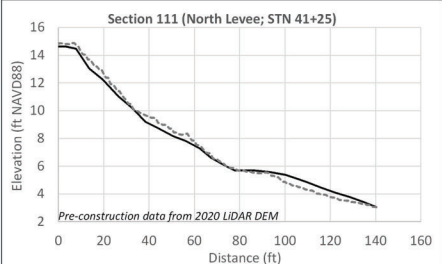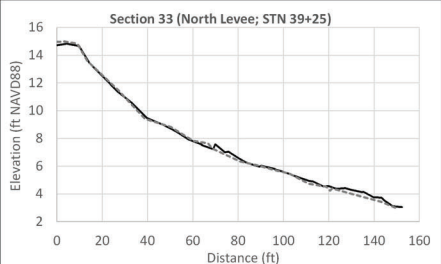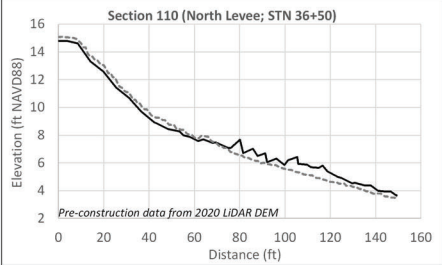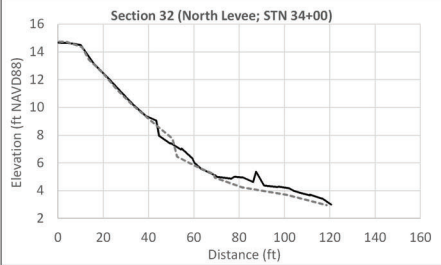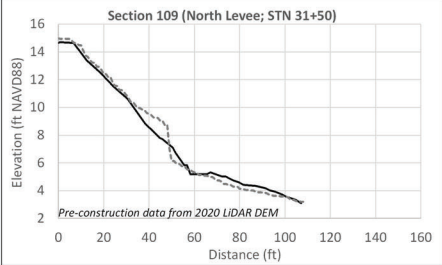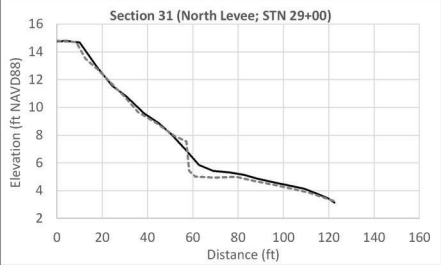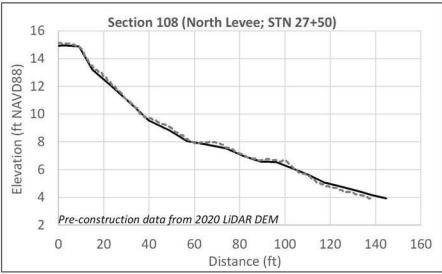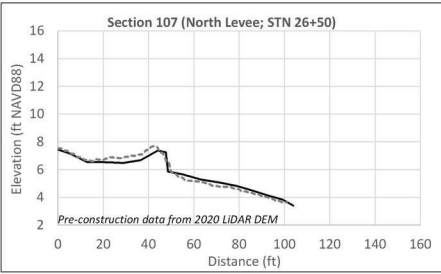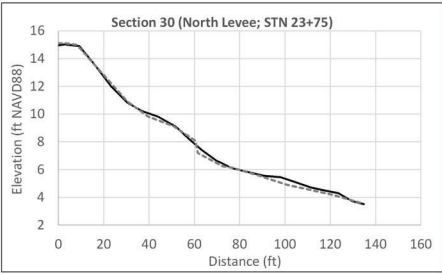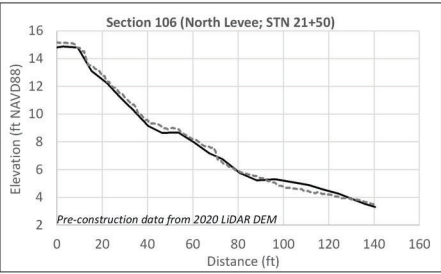

NUMBER	DATE	DESCRIPTION	BY	REVISION BLOCK	DRAWN BY: DAG	DESIGNED BY: PRB, RDL, SWS, DAG	CHECKED BY: RDL	SCALE: 1:3,600	Submitted: _____	Principal Civil Engineer	APPROVED BY: _____	PERMITTEE: _____	DATE: _____	Sonoma Land Trust	Siegel Environmental	Gillenwater Consulting	FarWest Restoration Engineering	Peter Baye, Ph.D.	AS-BUILT TOPOGRAPHIC SECTIONS (2)	DATE: 1/26/2022	SHEET: 10	PROJECT NO. 3021
--------	------	-------------	----	----------------	---------------	---------------------------------	-----------------	----------------	------------------	--------------------------	--------------------	------------------	-------------	-------------------	----------------------	------------------------	---------------------------------	-------------------	-----------------------------------	-----------------	-----------	------------------

Appendix E-4

Map Legend

Design Treatments

Treatment Approach	Scarp Grading	LWD Placement	Mud Placement	Brush Fence	Veneer (lower)
No Color Approach A			NO TREATMENT		
Approach B					
Approach C					
Approach D					
Approach E					
Approach F					
Approach G					
Approach H					
Approach I					

Field Added Treatments
















- Mud Placement (above MHHW)
- Gravel Toe Berm (above MHHW)
- Gravel Veneer (above MHHW)
- Topographic Sections

Topographic Section Plot Legend

- Pre-Construction Topography
- Post-Construction Topography

Notes

- Post-construction (as-built) topography surveyed by Dixon Marine Services between November 5 and 26, 2021 using RTK GPS.
- Pre-construction topography is from the following sources:
 - Sections 11 - 47: May 6, 2021 topographic survey performed by Daniel Harris of SFSU using RTK GPS.
 - Sections 101 - 121: June 2020 LiDAR digital elevation model (DEM) of Sears Pt Restoration Project site by Quantum Spatial.
- Topographic survey data are held to the benchmark network shown on Sheet 2
- Considerations for 2020 LiDAR data:
 - Data gaps along sections are due to the presense of standing water at the time of LiDAR acquisition.
 - Vegetation interference may be present in some locations, resulting in artificially high elevations.

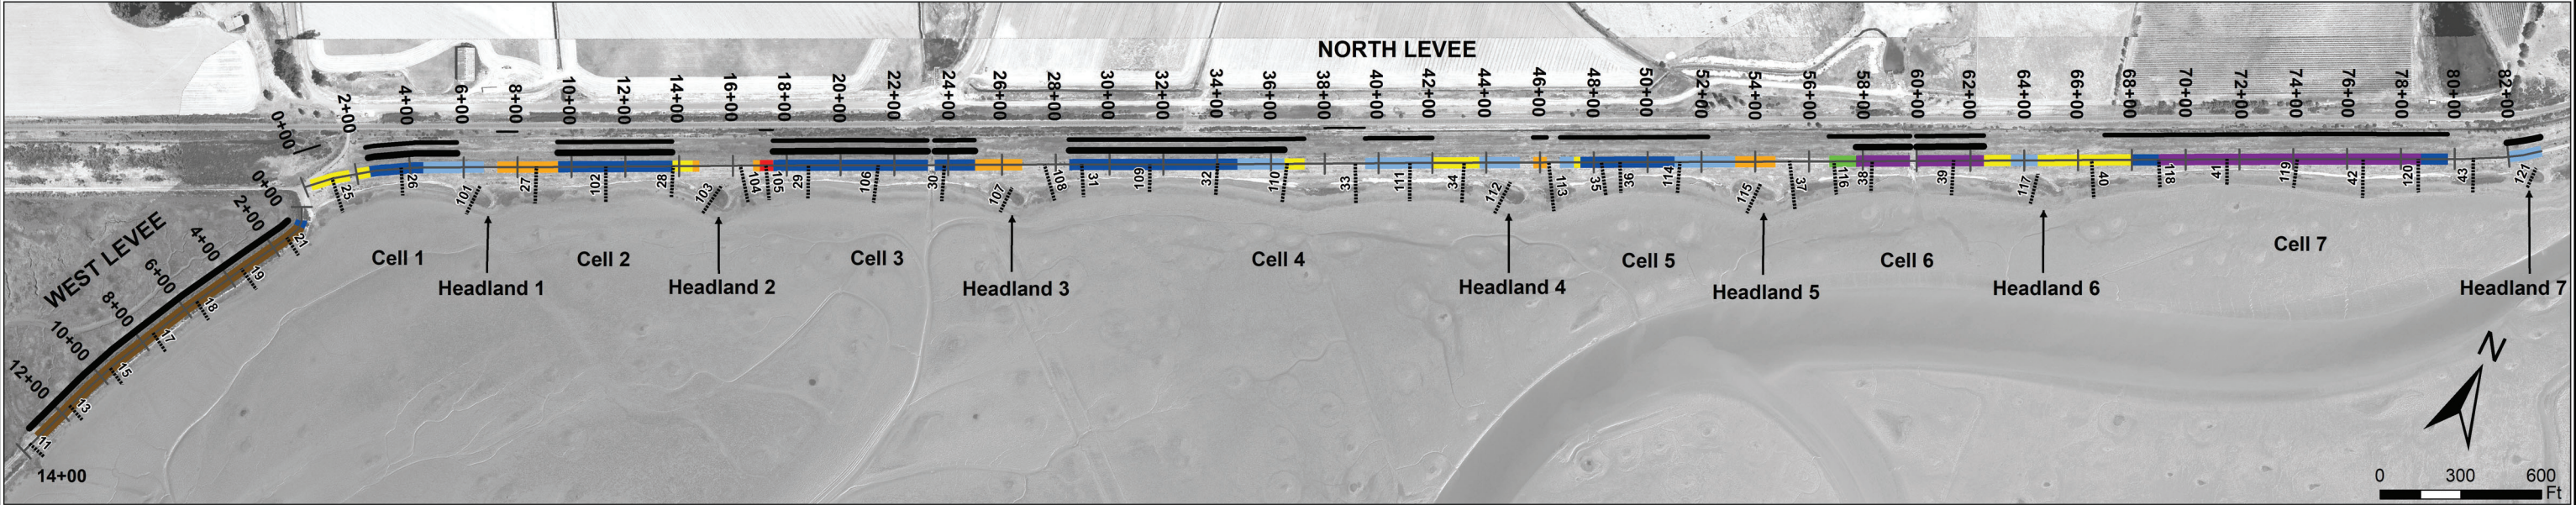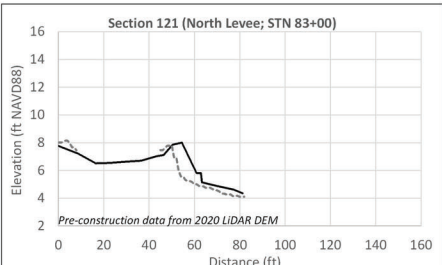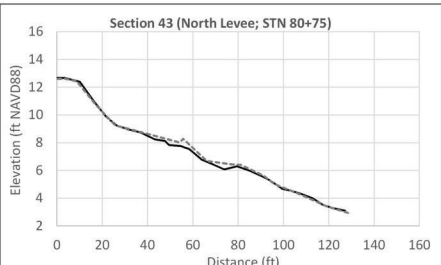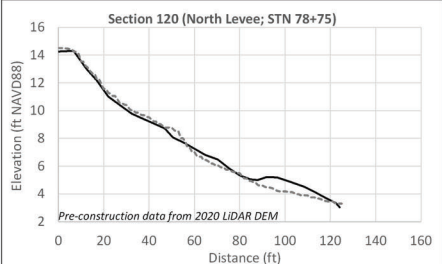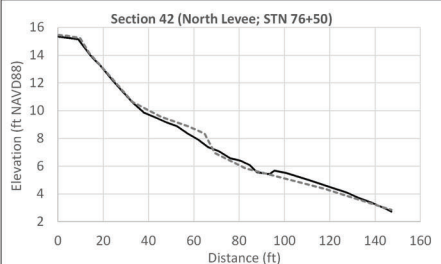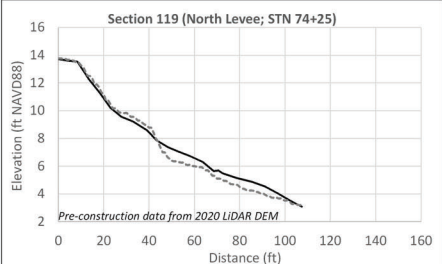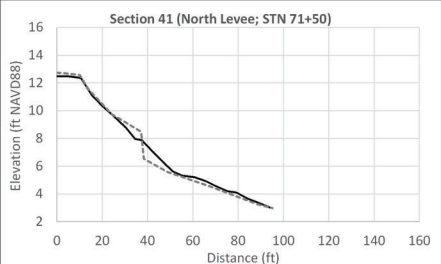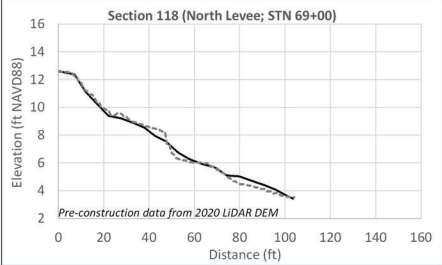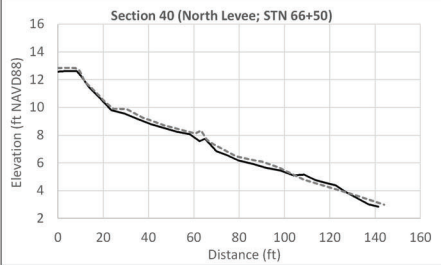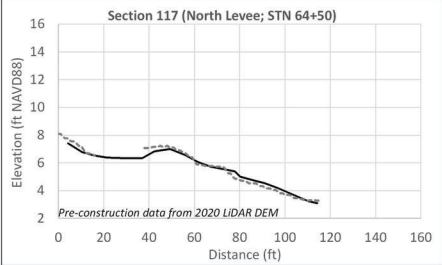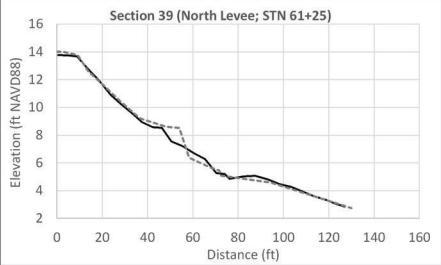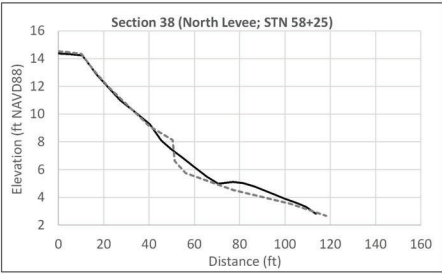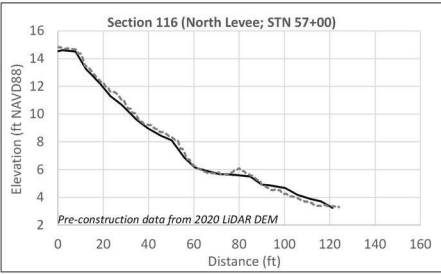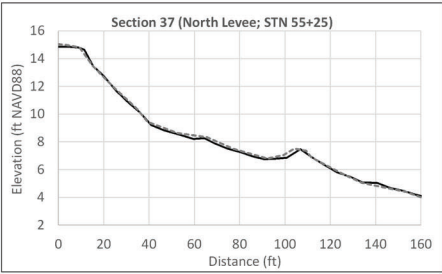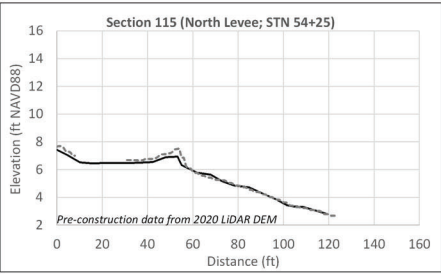

				REVISION BLOCK	DRAWN BY: DAG
					DESIGNED BY: PRB, RDL, SWS, DAG
					CHECKED BY: RDL
					SCALE: 1:3,600
NUMBER	DATE	DESCRIPTION	BY		

Levee Erosion
Adaptive Management Project
Sears Point Tidal Marsh Restoration Project
Sonoma County, CA

Submitted: _____
Principal Civil Engineer
APPROVED BY: _____
PERMITTEE: _____ DATE: _____



Peter Baye, Ph.D.

AS-BUILT TOPOGRAPHIC
SECTIONS (3)

DATE:
1/26/2022
SHEET:
11
PROJECT NO.
3021